

Jumbo deck barge


Vessel identification

The jumbo is suited for general construction and transportation. She has been used for stone placing and as a platform for piling, dredging and demolition.


Type of vessel	Construction deck barge
Build date	1973
Port of registry	Durban
Official no.	20001
Category	VIII
Flag	SAMSA
Propulsion method	None

Dimensions and weight


Gross tonnage	721 tons
Net tonnage	216 tons
Overall length	46.85m
Breadth	17.07m
Lightship displacement	342.04 tons
Loadline displacement	2200 tons
Lightship draught	0.646m
Loadline draught	2.9m
Tanks	12 x Ballast tanks

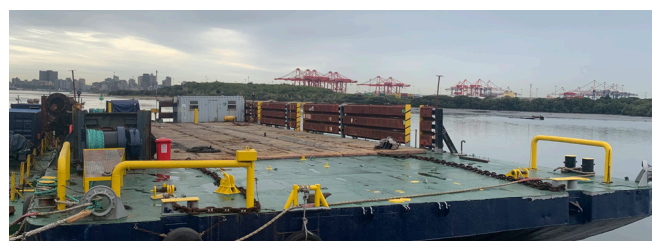

Copyright: This document is the property of Subtech and shall not be copied or used wholly or in part without prior written consent of the company.

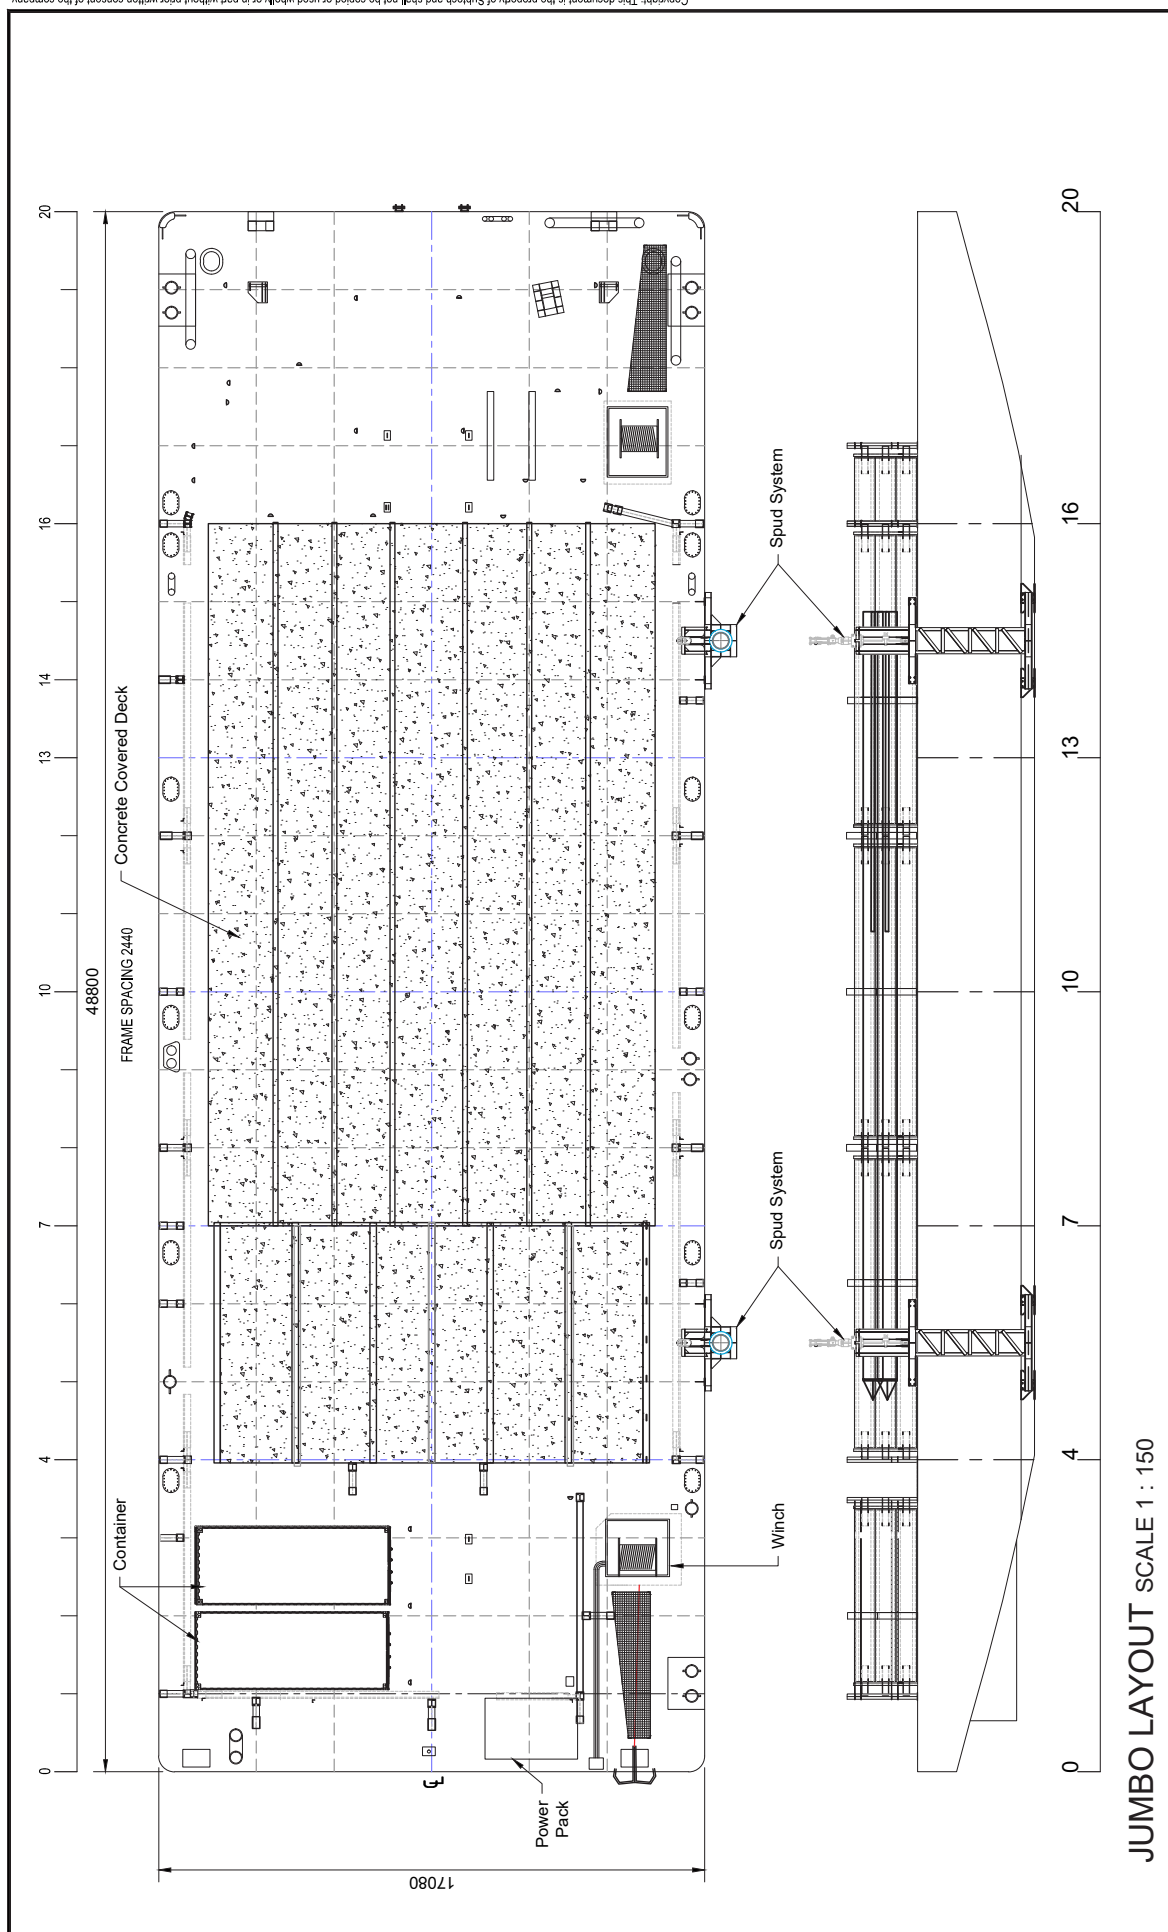

JUMBO LAYOUT SCALE 1 : 150

The JUMBO BARGE AS BUILT LAYOUT		Drawing number PLANT - 3015 - PWD - 100 - 3				
Engineer Drawn Date Scale		Sheet 1 of 1 Rian Verler 12/07/2022 1 : 150 A3				
James Fisher Subtech						
Rev	Date	Prepared by	Checked by	Approved by	Description	Status
3	01/11/22	R.V	J.M	J.M	SPUDBOX ADDED	SFR